


# FLORENCE REGIONAL SEWER DISTRICT FLORENCE-MARKLAND SEWER EXTENSION

## FLORENCE REGIONAL SEWER DISTRICT

ROBERT WHEELER, *President*  
LARRY STEWART, *Vice President*  
PATRICIA CHASE, *Secretary/Treasurer*  
ART ADAMS  
JACK KIDWELL

APPROVED:

\_\_\_\_\_  
\_\_\_\_\_  
\_\_\_\_\_  
\_\_\_\_\_

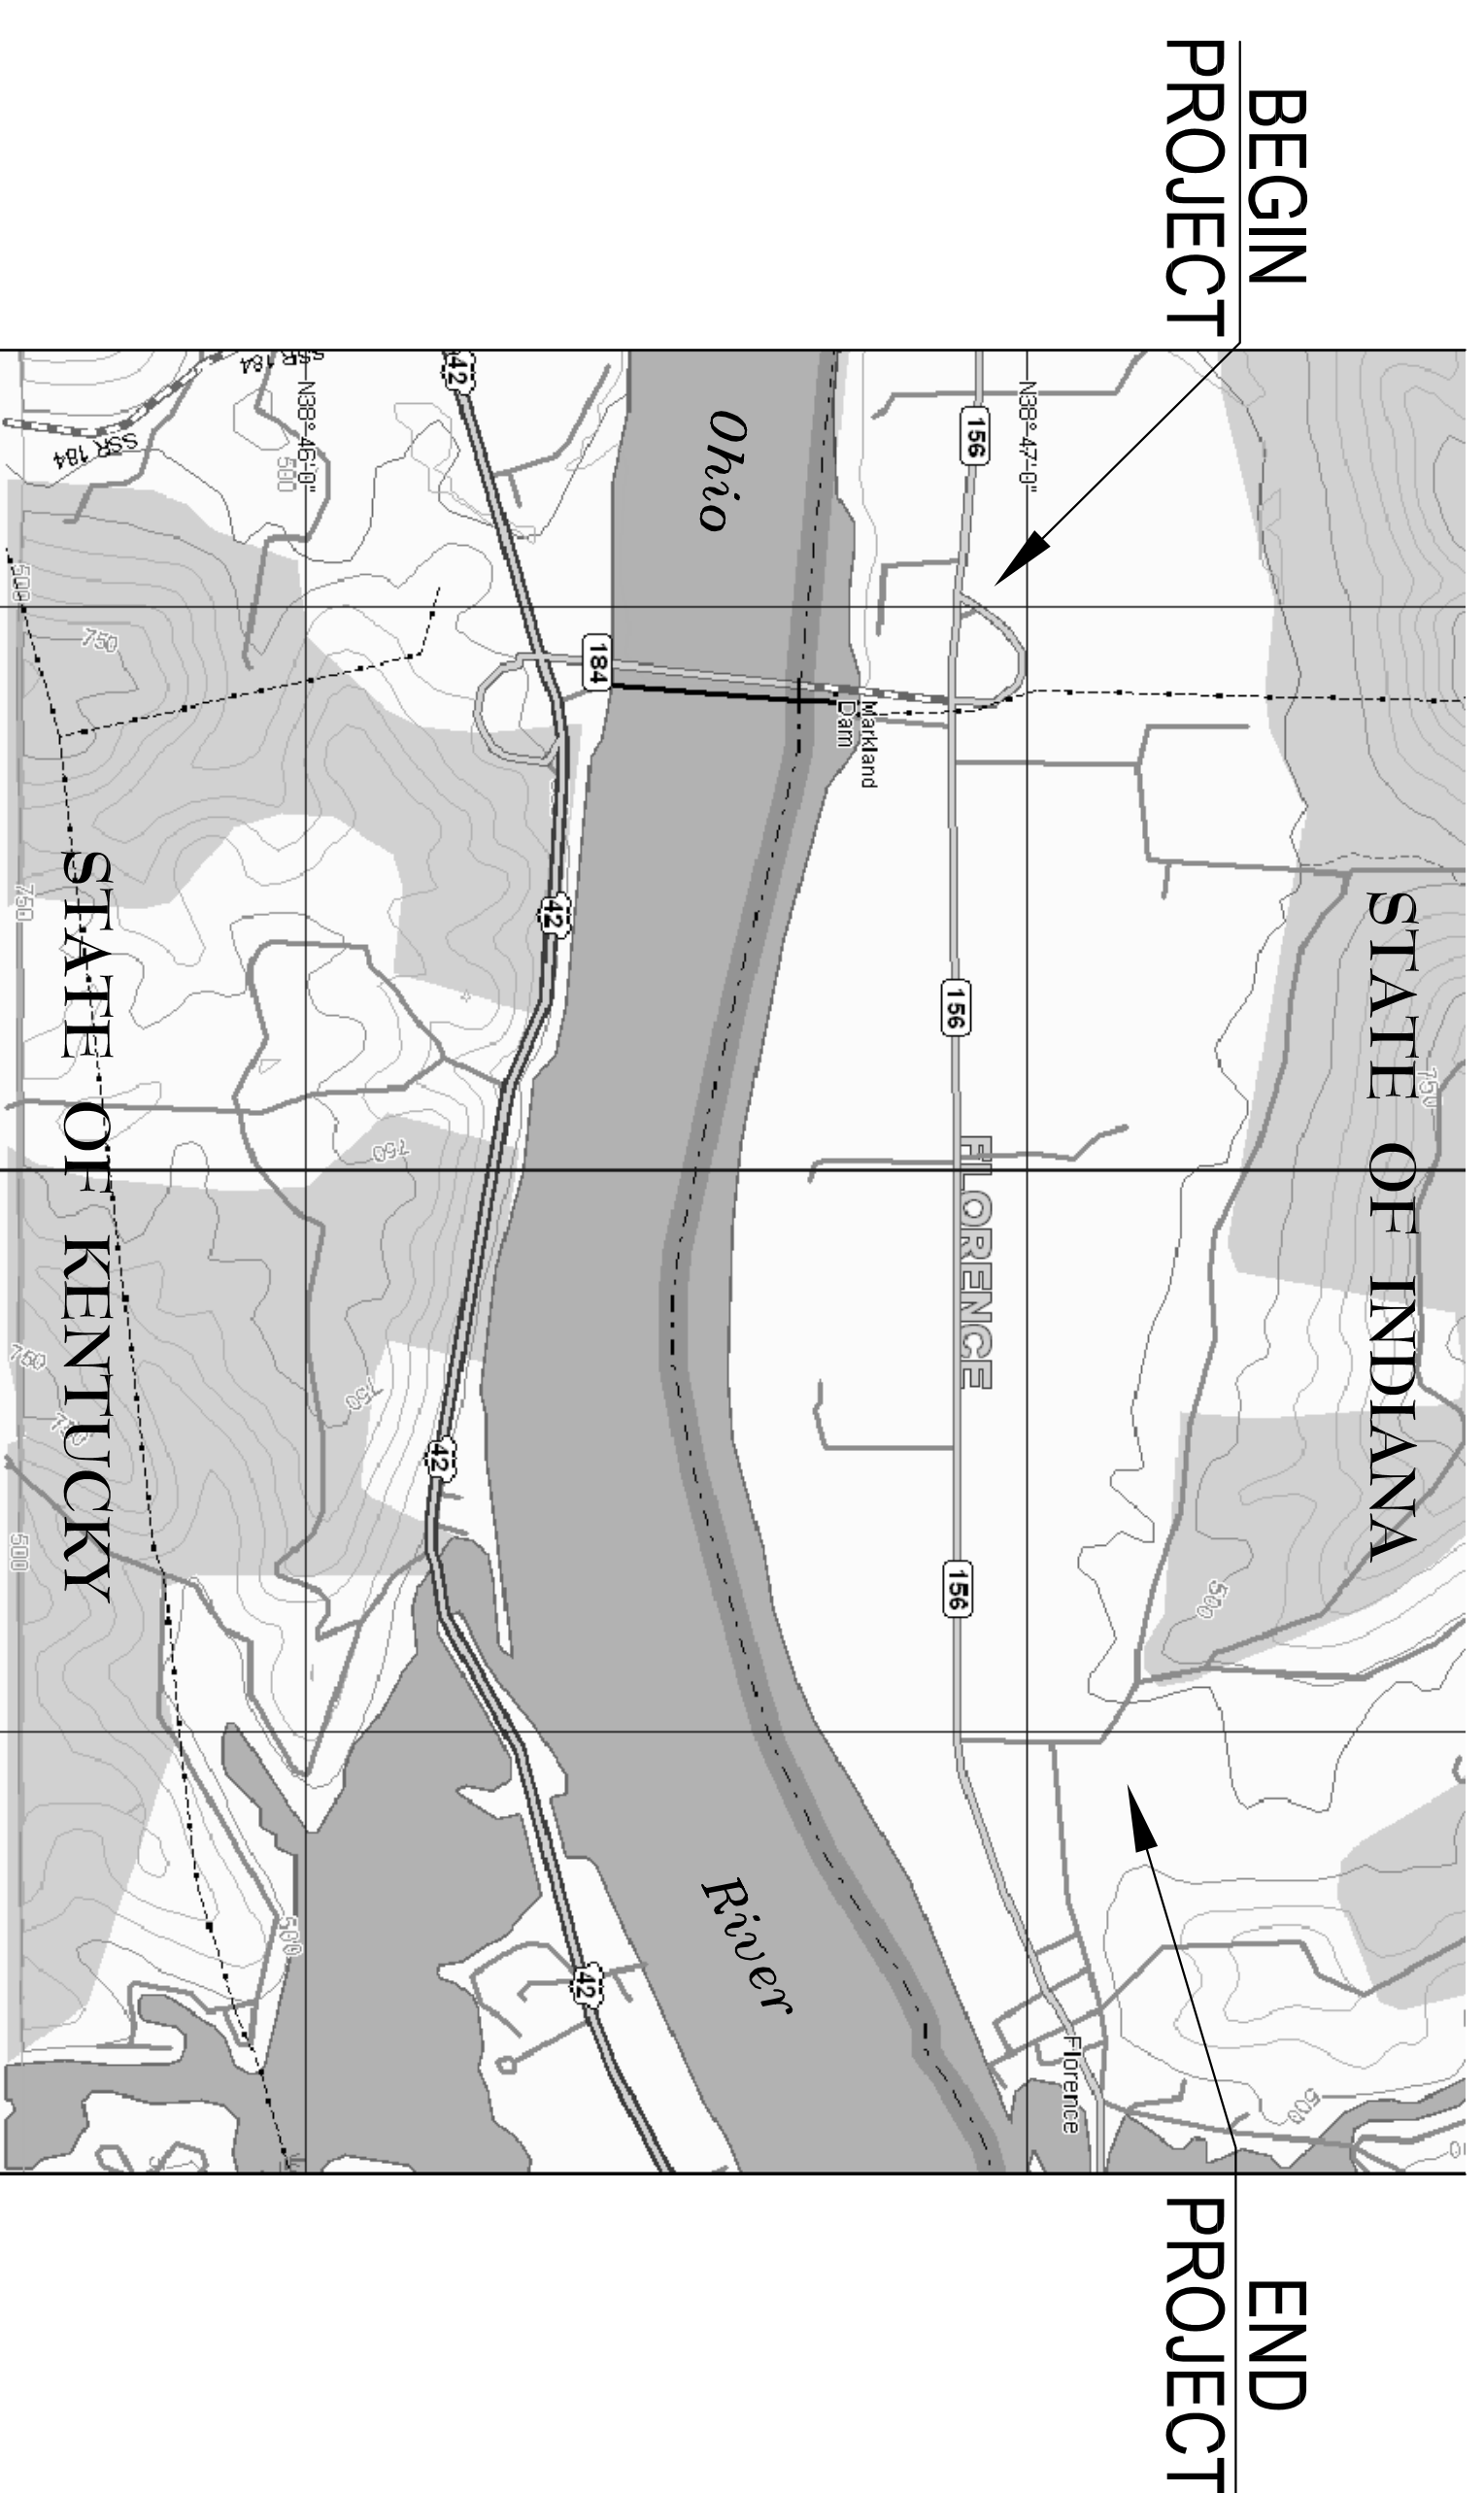


## INDEX

DESCRIPTION	SHEET #
Title & Index	1
Plan & Profile - Line 1.00	2
Plan & Profile - Line 2.00	3
Plan & Profile - Line 2.10	4
Plan - Force Main	5
Plan - Force Main	6
Plan - Force Main	7
Detail- Line 2.00 at S.R. 101 Bridge	8
Lift Station Details	9

*Florence-Markland Sewer Extension*  
*Town of Florence*  
*Switzerland Co., Indiana*

## HOWARD J. BARTH & ASSOCIATES

ENGINEERS - DESIGNERS  
347 E. Washington Street  
Greensburg, Indiana 47240

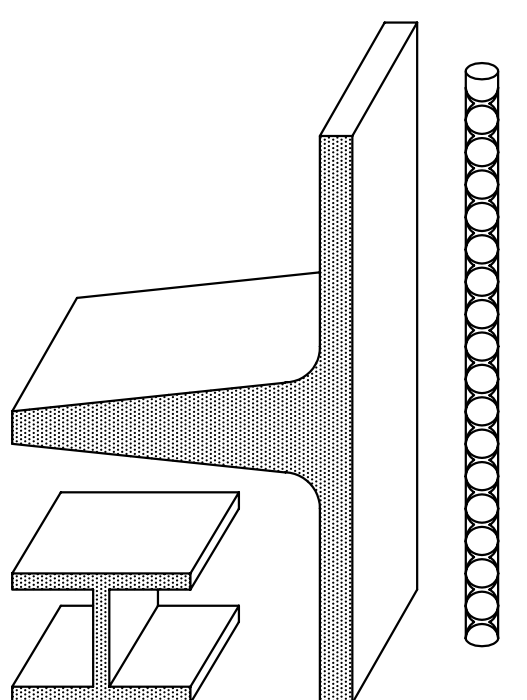

**RECORD DRAWINGS**  
These Record documents have been prepared based on information provided by others. The Design Professional has not verified the accuracy and/or completeness of this information and shall not be responsible for any errors or omissions which may be incorporated herein as a result.