


PLAN - FORCE MAIN

SCALE: 1"=50'


- LEGEND**
- ⊗ AIR RELIEF VALVE
 - ⊗x PLUG VALVE and BOX

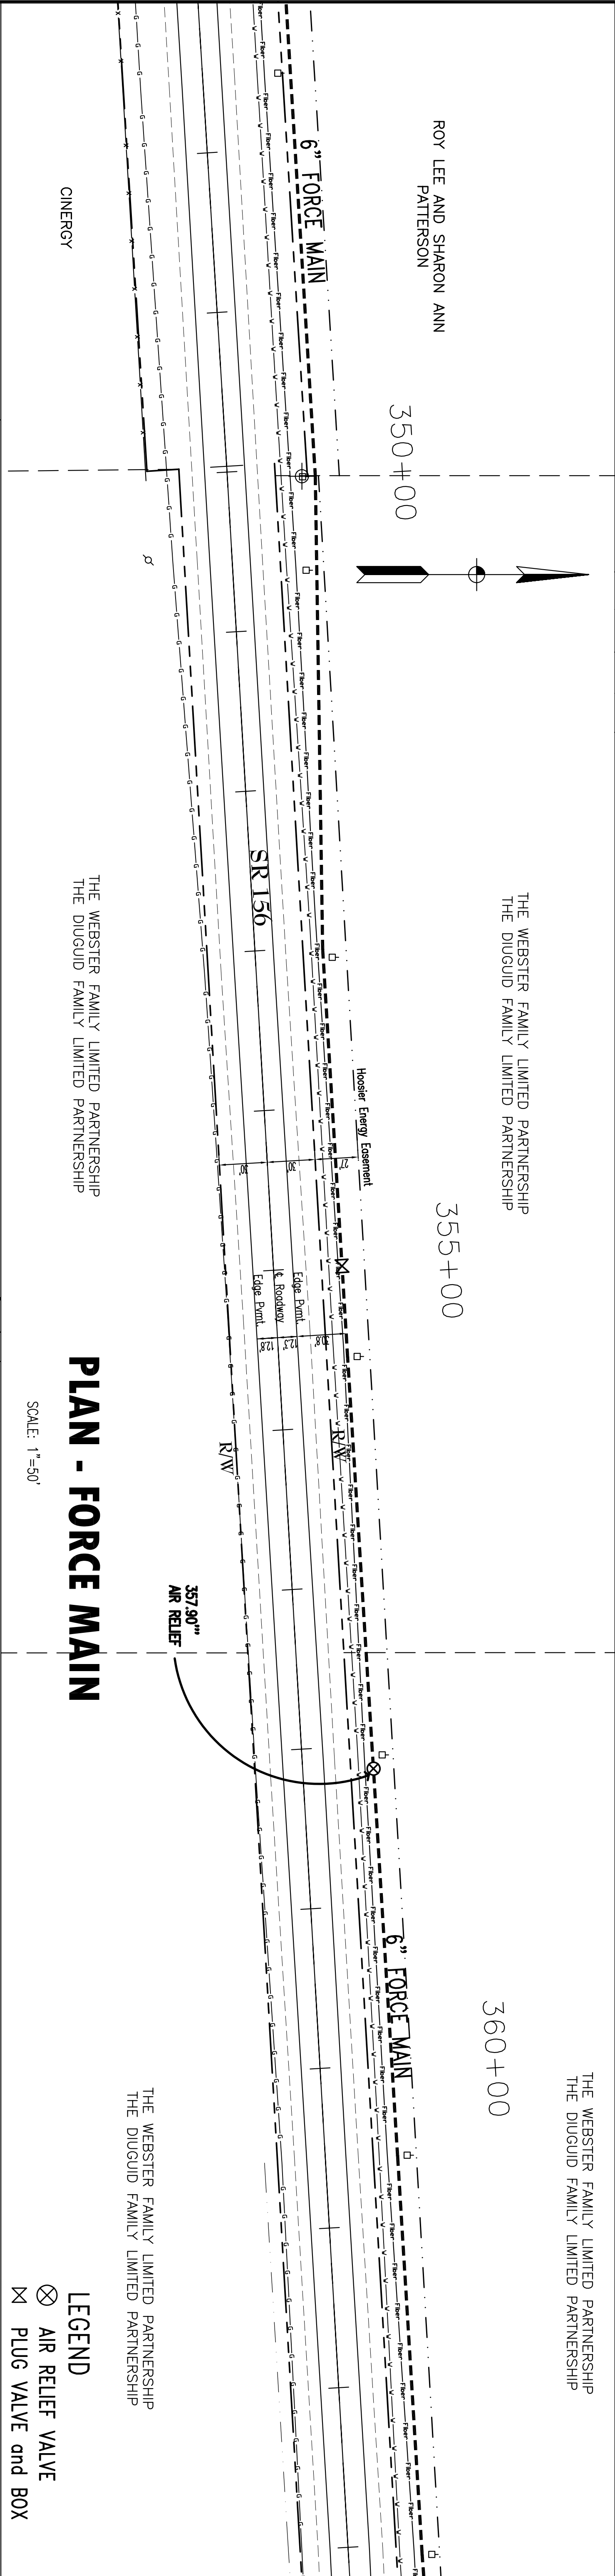

PLAN - FORCE MAIN

SCALE: 1"=50'

- LEGEND**
- ⊗ AIR RELIEF VALVE
 - ⊗x PLUG VALVE and BOX

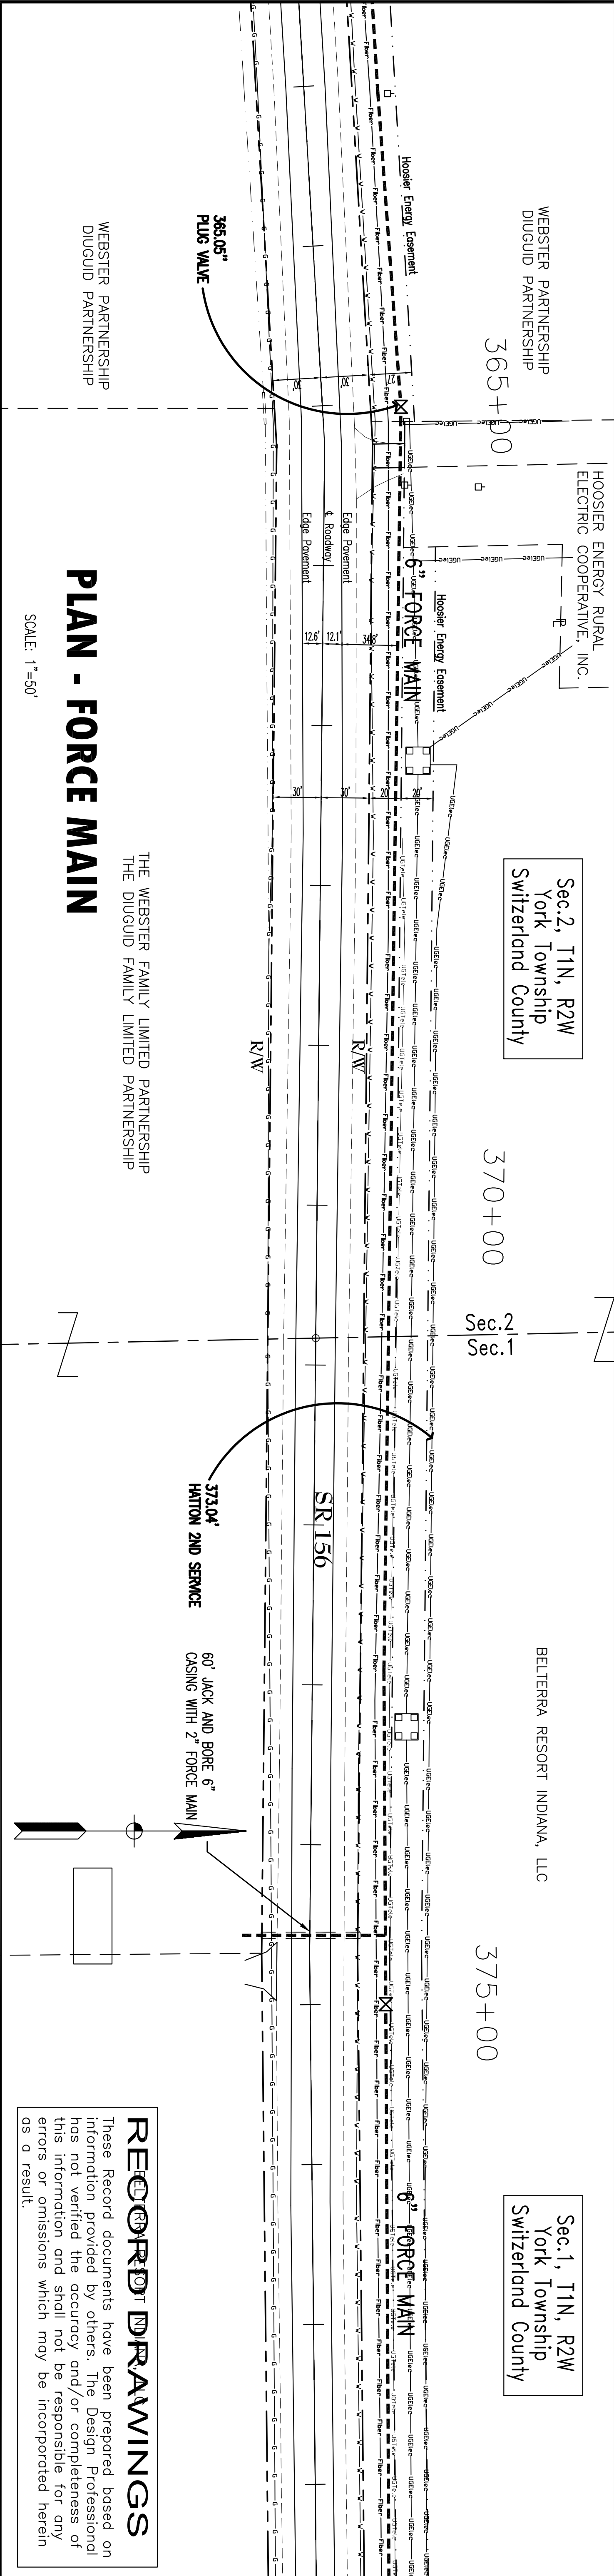

PLAN - FORCE MAIN

SCALE: 1"=50'

- LEGEND**
- ⊗ AIR RELIEF VALVE
 - ⊗x PLUG VALVE and BOX

Sec. 2, T1N, R2W
York Township
Switzerland County

ROY LEE AND SHARON ANN PATTERSON

Sec. 2, T1N, R2W
York Township
Switzerland County

BELTERRA RESORT INDIANA, LLC

Sec. 1, T1N, R2W
York Township
Switzerland County

RECORD DRAWINGS

These Record documents have been prepared based on information provided by others. The Design Professional has not verified the accuracy and/or completeness of this information and shall not be responsible for any errors or omissions which may be incorporated herein as a result.

| <p>FORCE MAIN</p> <p>Florence Regional Sewer District Town of Florence, Indiana</p> | <p>JOB NO 01-2748 DWN BY brk CHK BY jjs DATE 4/02 SCALE 1"=50'</p> | <table border="1" style="width: 100%; border-collapse: collapse;"> <thead> <tr> <th style="width: 5%;">NO</th> <th style="width: 80%;">DESCRIPTION</th> <th style="width: 15%;">BY</th> <th style="width: 10%;">DATE</th> </tr> </thead> <tbody> <tr> <td> </td> <td> </td> <td> </td> <td> </td> </tr> <tr> <td> </td> <td> </td> <td> </td> <td> </td> </tr> <tr> <td> </td> <td> </td> <td> </td> <td> </td> </tr> </tbody> </table> | NO | DESCRIPTION | BY | DATE | | | | | | | | | | | | | <p>HOWARD J. BARTH & ASSOCIATES, INC.</p> <p>CONSULTING ENGINEERS</p> <p>347 E. WASHINGTON STREET GREENSBURG, INDIANA 47240 812-663-2177 FAX 812-663-7906</p> | |
|--|--|---|------|-------------|----|------|--|--|--|--|--|--|--|--|--|--|--|--|--|--|
| NO | DESCRIPTION | BY | DATE | | | | | | | | | | | | | | | | | |
| | | | | | | | | | | | | | | | | | | | | |
| | | | | | | | | | | | | | | | | | | | | |
| | | | | | | | | | | | | | | | | | | | | |
| <p>SHEET NUMBER</p> <p>5</p> | <p>© copyright 2002</p> | | | | | | | | | | | | | | | | | | | |