


PLAN - FORCE MAIN

SCALE: 1"=50'


- LEGEND**
- ⊗ AIR RELIEF VALVE
 - ⊗x PLUG VALVE and BOX

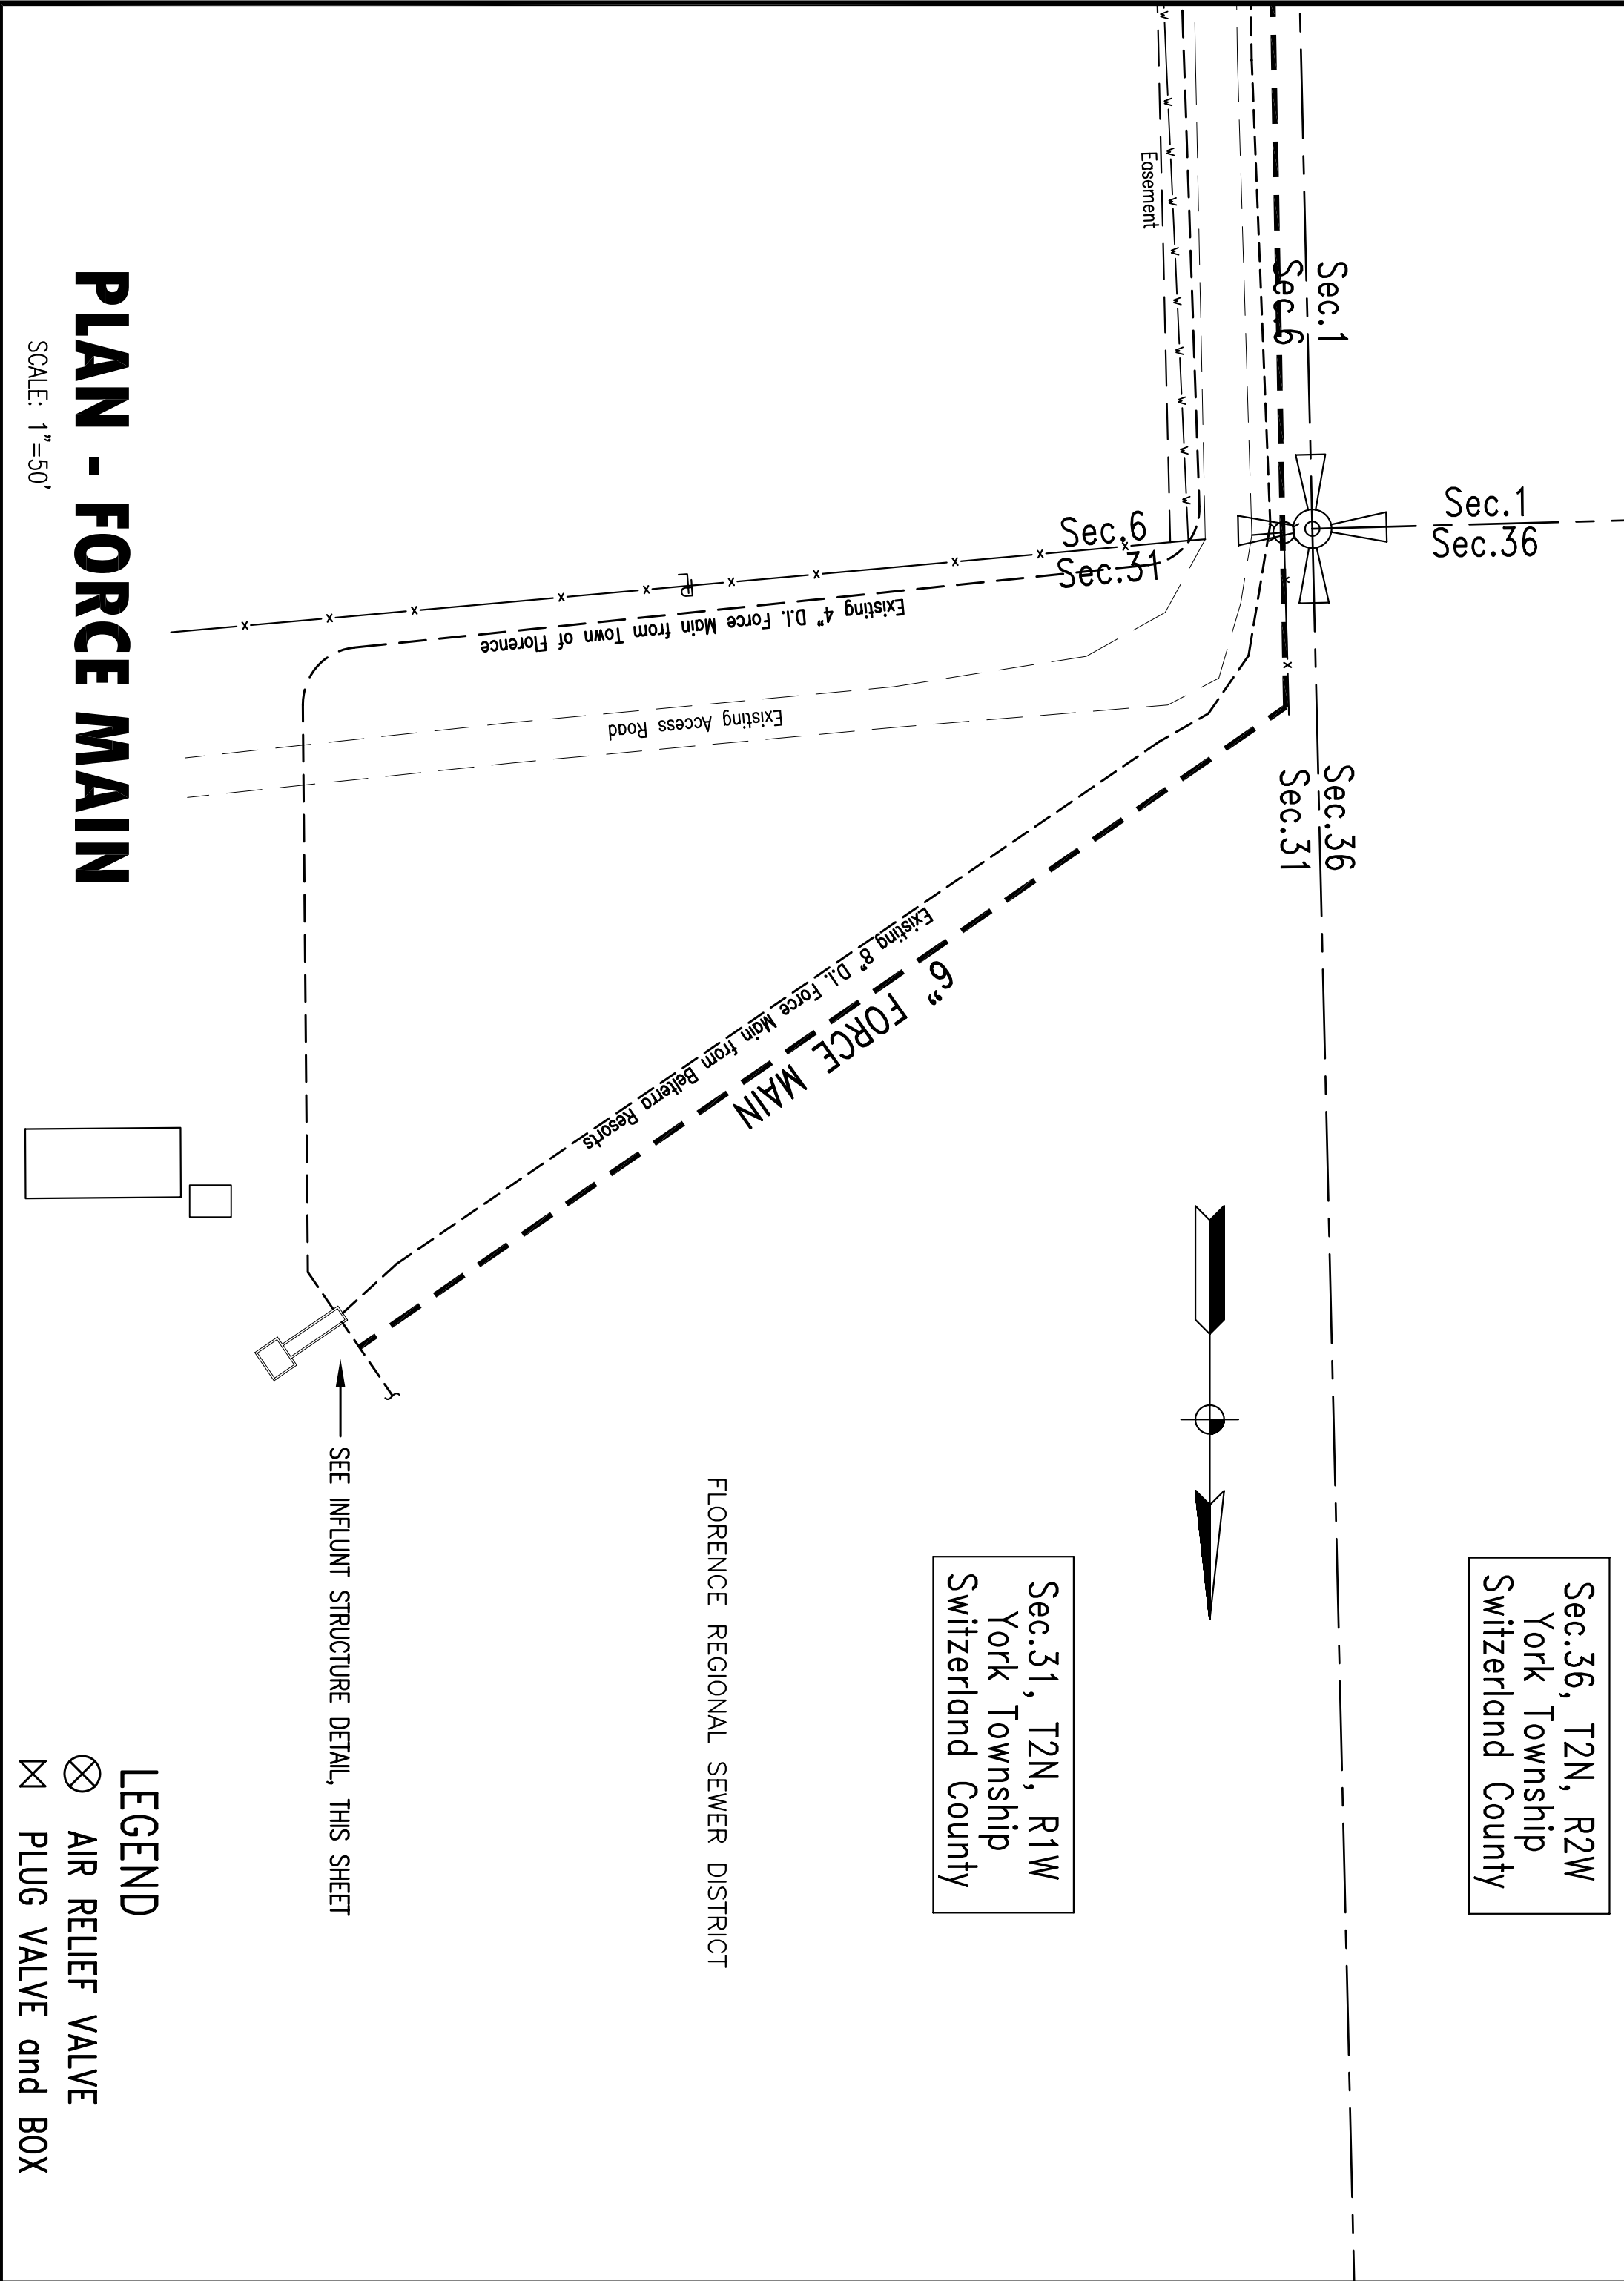

PLAN - FORCE MAIN

SCALE: 1"=50'

- LEGEND**
- ⊗ AIR RELIEF VALVE
 - ⊗x PLUG VALVE and BOX

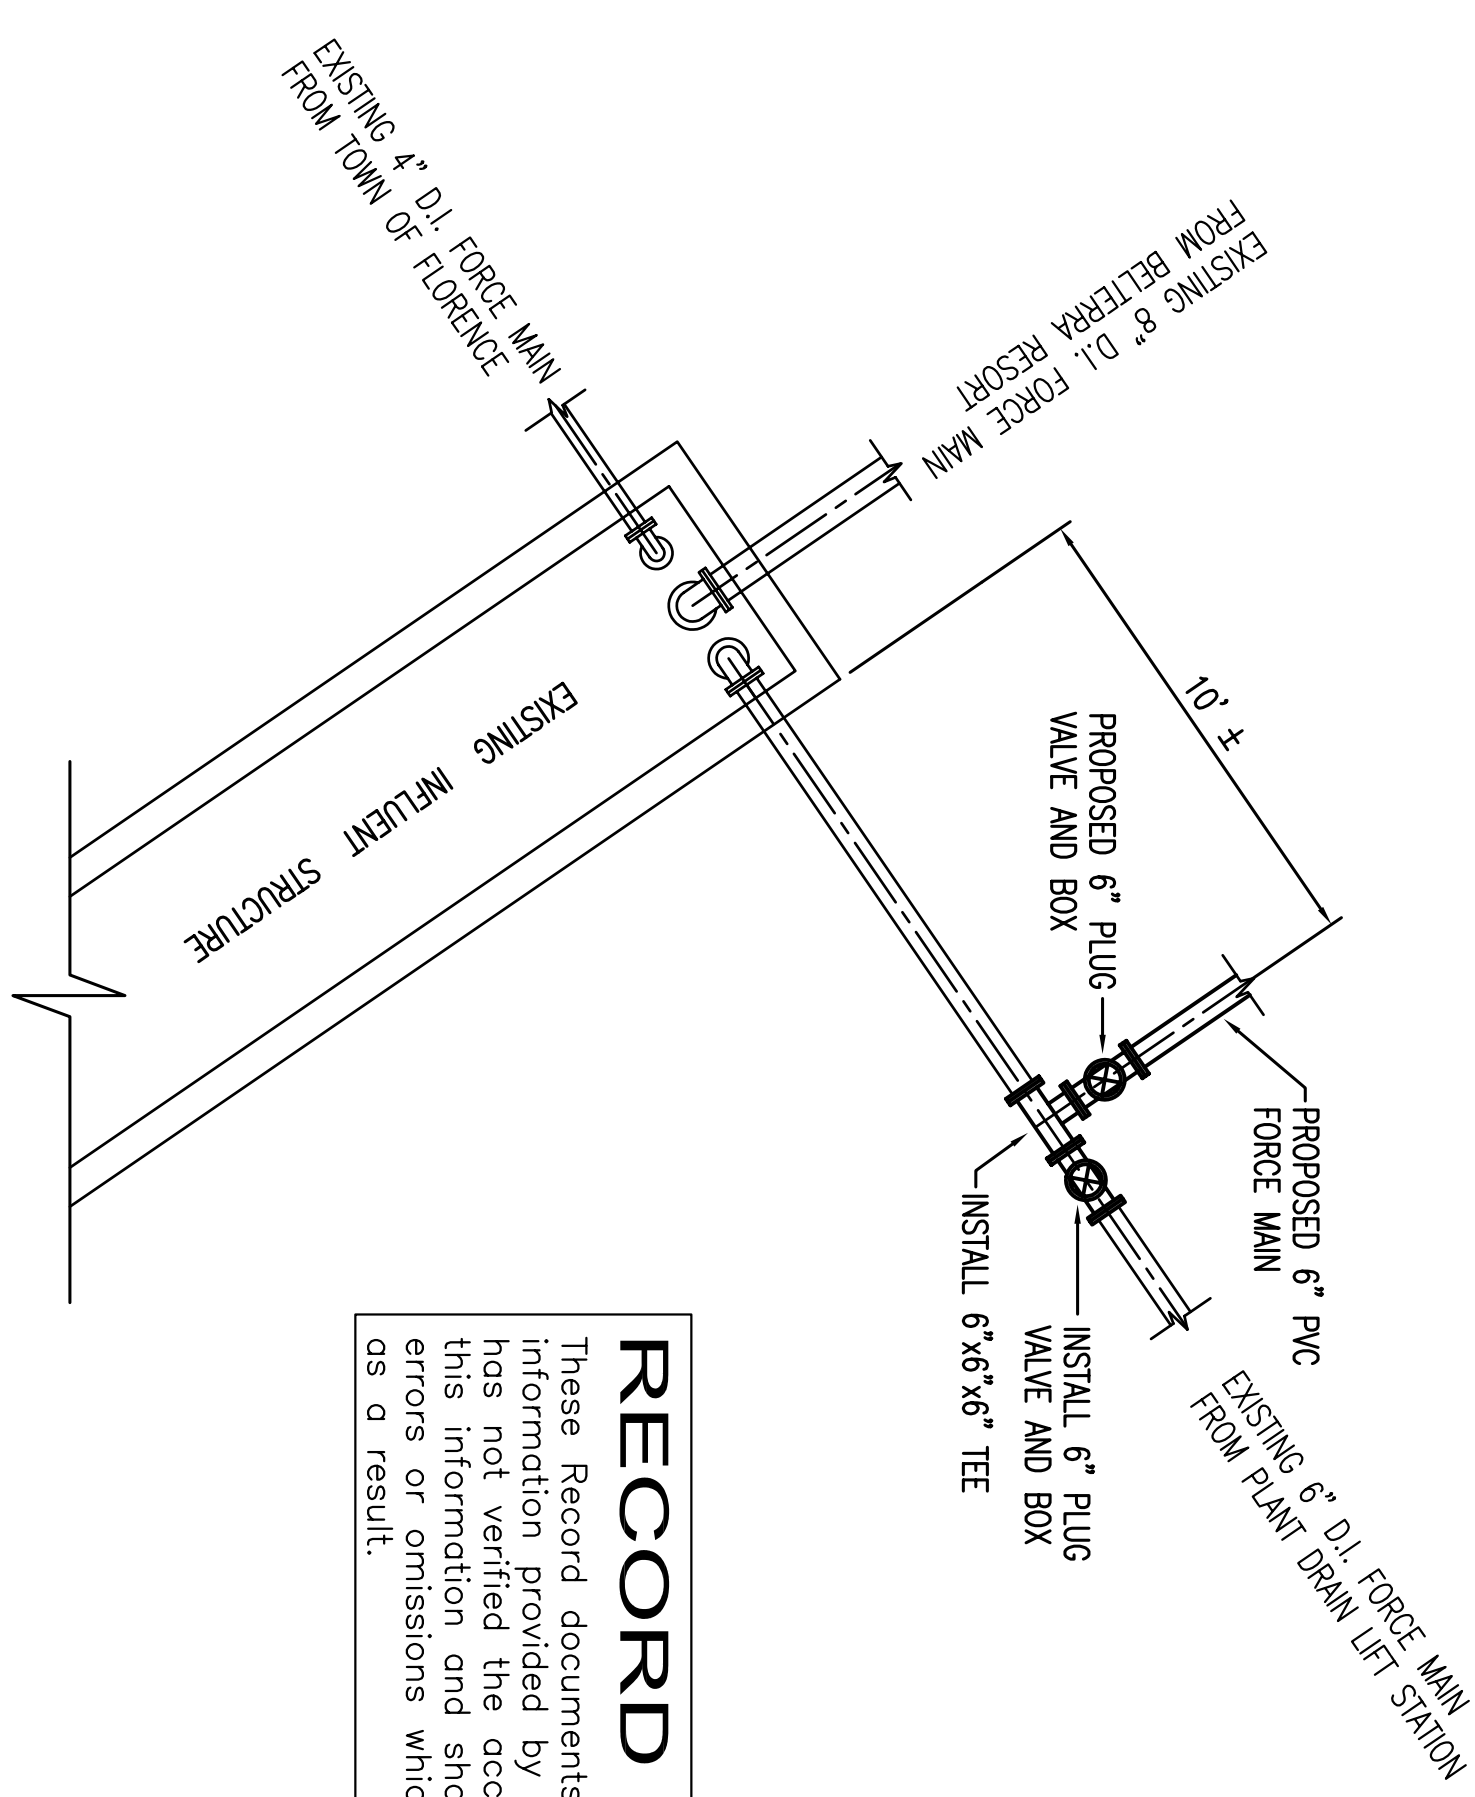

INFLUENT STRUCTURE DETAIL

Not to Scale

RECORD DRAWINGS

These Record documents have been prepared based on information provided by others. The Design Professional has not verified the accuracy and/or completeness of this information and shall not be responsible for any errors or omissions which may be incorporated herein as a result.

<p>FORCE MAIN INFLUENT STRUCTURE DETAIL</p> <p>Florence Regional Sewer District Town of Florence, Indiana</p>	<p>JOB NO 01-2748</p> <p>DWN BY brk</p> <p>CHK BY jjg</p> <p>DATE 4/02</p> <p>SCALE 1" = 50'</p>	<table border="1" style="width: 100%; border-collapse: collapse;"> <thead> <tr> <th>NO</th> <th>DESCRIPTION</th> <th>BY</th> <th>DATE</th> </tr> </thead> <tbody> <tr><td> </td><td> </td><td> </td><td> </td></tr> <tr><td> </td><td> </td><td> </td><td> </td></tr> <tr><td> </td><td> </td><td> </td><td> </td></tr> <tr><td> </td><td> </td><td> </td><td> </td></tr> </tbody> </table>	NO	DESCRIPTION	BY	DATE																	<p>HOWARD J. BARTH & ASSOCIATES, INC.</p> <p>CONSULTING ENGINEERS</p> <p>347 E. WASHINGTON STREET GREENSBURG, INDIANA 47240 812-663-2177 FAX 812/663-7906</p>	
NO	DESCRIPTION	BY	DATE																					
<p>SHEET NUMBER 7</p>	<p>© copyright 2002</p>																							